


BASEMENT PLAN

SCALE N.T.S.


Basement AREA : 970 sq ft

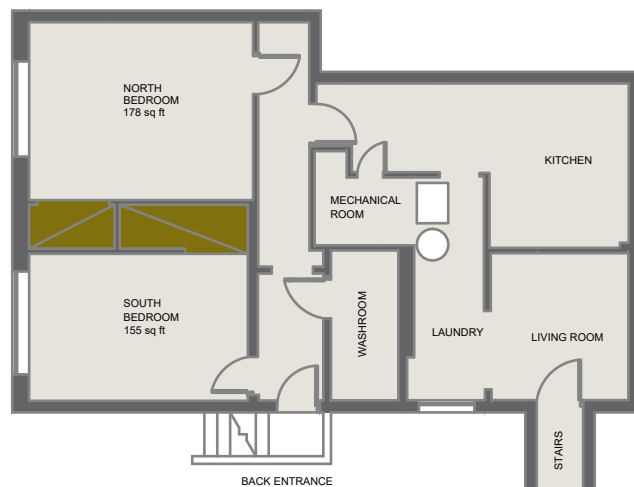

FIRST FLOOR PLAN

SCALE N.T.S.

First Floor AREA : 1536 sq ft

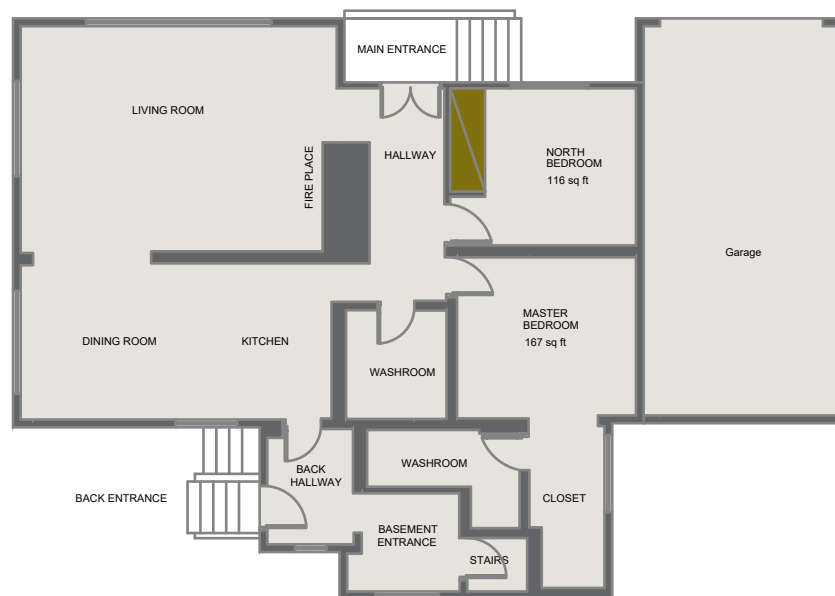

LEGEND / REMARKS

REV.	DATE	NAME	REMARKS		
REVISION GUIDE					
A,B,C, To Preliminary			0 First Issue		
1,2,3, To Construction			Z To As Built		
PROJECT :					
1510 Alward st.					
DRAWING TITLE :					
AS BUILT					
		COMPANY & LIABE	DATE	ARCHIVE CODE	SCALE
DESIGN	-	--	-		SIZE A1
DRAWN	-	--	-		
CHECK	-	--	-		
APPROVAL	-	--	-		
CONTRACT NO. :			DESIGN STAGE :		
LOCATION :			FILE NO. :		
DRAWING No.					REV.
		SURVEXI		1 DWG	